


TYPICAL LEDGER DETAIL

**2x4 LEDGER ATTACHED TO TOP AND BOTTOM
OF SUPPORTING MEMBERS PER DETAIL PROVIDED**

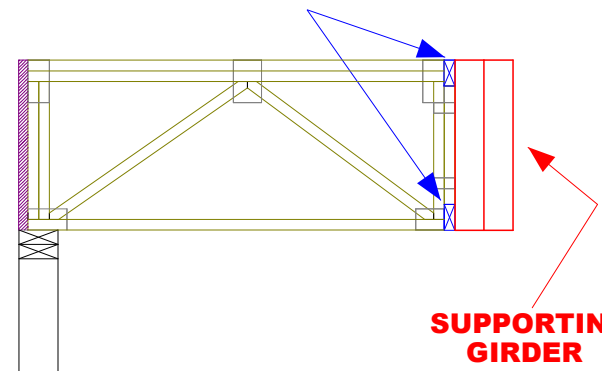

HANGER SCHEDULE

● = SIMPSON THA426 (7)

● = SIMPSON THAC426 (2)

**▲ = USE TAGGED/LABELED ENDS OF TRUSSES
TOWARD DIRECTIONS SHOWN**
(TAGGED/LEFT END OF TRUSSES = LEFT SIDE OF ENG. DWGS.)

- ☐ No Exception Taken
 ☐ Rejected
☒ Make Corrections as Noted
 ☐ Submit Specified Item
☐ Revise and Resubmit
 ☐ Not Reviewed

Submittal is reviewed only as to general conformity with design concept of the project and general compliance with the information given in the Contract Documents. Corrections and/or comments made as part of this submittal review do not relieve contractor of responsibility from conformance with the Contract Documents, applicable codes, and laws - all of which have priority over this submittal. The design professional does not warrant or represent that the information within the submittal is either accurate or complete. Sole responsibility for correct design, details, and dimensions shall remain with the party providing the submittal. Contractor is responsible for all dimensions, quantities and performance requirements to be confirmed and correlated at the job site; for all information that pertains solely to the fabrication processes or to techniques of construction; for all coordination of the work of all trades; for assuring consistency with the Contract Documents; and for performing the work in a safe and satisfactory manner.

openingdesign


Reviewed by: Ryan Schultz
Luis C. Pérez Tato
Kurt Frey

**NOTE:
CONTRACTOR MUST
SUPPLY AND SET 2x6 STRONG-BACKS
PER ENCLOSED TRUSS DRAWINGS**

 = 2x4 LEDGERS WHERE SHOWN BY OTHERS

 = RIMBOARD PER PLAN BY OTHERS

 = FLUSH BEAM PER PLAN BY OTHERS

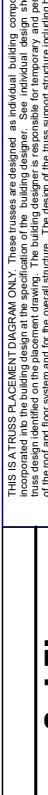 SELECT Trusses & Lumber, Inc.	Client: Arrow-Chippewa Falls		Job Desc.: Cannery 3rd-Floor		Site Information:		
	Address:						
	Telephone:	Fax:	Contact:	Jon Sorenson	Telephone:	Fax:	
	Scale:	NTS	Date:	3/17/2020	Drawn By:	JDH	
				Job # 63378		Approved by:	Date Approved: