
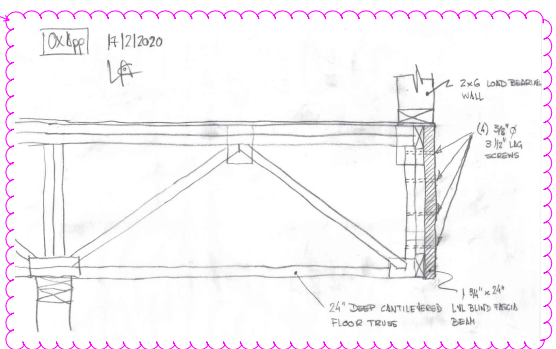



▲ = USE TAGGED/LABELED ENDS OF TRUSSES TOWARD DIRECTIONS SHOWN
(TAGGED/LEFT END OF TRUSSES = LEFT SIDE OF ENG. DWGS.)

provide strongback bridging every 10ft

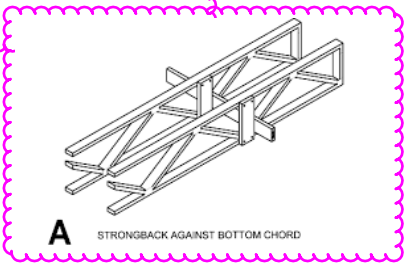

TYPICAL LEDGER DETAIL

2x4 LEDGER ATTACHED TO TOP AND BOTTOM OF SUPPORTING MEMBERS PER DETAIL PROVIDED

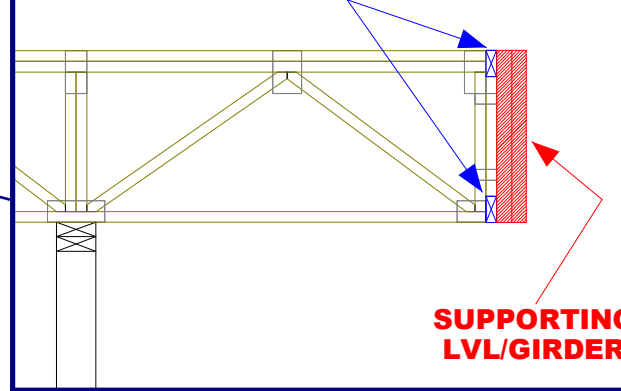

HANGER SCHEDULE

- = SIMPSON THA426 (18)
- = SIMPSON THAC426 (6)

- ☐ No Exception Taken
- ☐ Rejected
- ☒ Make Corrections as Noted
- ☐ Submit Specified Item
- ☐ Revise and Resubmit
- ☐ Not Reviewed

Submittal is reviewed only as to general conformity with design concept of the project and general compliance with the information given in the Contract Documents. Corrections and/or comments made as part of this submittal review do not relieve contractor of responsibility from conformance with the Contract Documents, applicable codes, and laws - all of which have priority over this submittal. The design professional does not warrant or represent that the information within the submittal is either accurate or complete. Sole responsibility for correct design, details, and dimensions shall remain with the party providing the submittal. Contractor is responsible for all dimensions, quantities and performance requirements to be confirmed and correlated at the job site; for all information that pertains solely to the fabrication processes or to techniques of construction; for all coordination of the work of all trades; for assuring consistency with the Contract Documents; and for performing the work in a safe and satisfactory manner.

openingdesign

Reviewed by: Ryan Schultz
Luis C. Pérez Tato
Date: 02.21.2019

NOTE: CONTRACTOR MUST SUPPLY AND SET 2x6 STRONG-BACKS PER ENCLOSED TRUSS DRAWINGS

- = 2x4 LEDGERS WHERE SHOWN BY OTHERS
- = RIMBOARD PER PLAN BY OTHERS
- = FLUSH BEAM PER PLAN BY OTHERS
- = STEEL BEAM PER PLAN BY OTHERS

Client: Arrow - Chippewa Falls

Address: Cannery Trail 2nd-Floor

Telephone: Jon Sorenson

Contact: 2/12/2020

Scale: NTS

Job Desc.: Cannery Trail 2nd-Floor

Site Information:

Telephone: Jon Sorenson

Contact: 2/12/2020

Scale: NTS

Job # 63377

Drawn By: JDH

Date: 2/12/2020

Scale: NTS

Truss Placement Plan

THIS IS A TRUSS PLACEMENT DIAGRAM ONLY. These trusses are designed as individual building components to be incorporated into the building design at the specification of the building designer. See individual design sheets for each truss layout. Review and approval of this layout must be received before any trusses are built. ANY TRUSS LAYOUTS, REVIEWS, AND APPROVALS OF THIS LAYOUT MUST BE RECEIVED BEFORE ANY TRUSSES WILL BE BUILT. ANY TRUSS LAYOUTS, REVIEWS, AND APPROVALS OF THIS LAYOUT MUST BE RECEIVED BEFORE ANY TRUSSES WILL BE BUILT. ANY TRUSS LAYOUTS, REVIEWS, AND APPROVALS OF THIS LAYOUT MUST BE RECEIVED BEFORE ANY TRUSSES WILL BE BUILT.

Trusses & Lumber, Inc.

Approved by:

Date Approved: